### GAS Furnace, heater, cooktop and fireplace

### Humifier valve needed, irrigation line needed

MASTER


BEDROOM

Master Bath - Optional Alternate Walk-In Shower

Scale: 1/4" = 1'-0"

D A201

ROOM

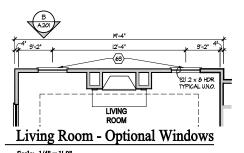

#### GENERAL NOTES

- I. EXTERIOR WALL DIMENSIONS INCLUDE THICKNESS OF SHEATHING
- 2. REFER TO SITE LAYOUT PLAN FOR BUILDING LOCATIONS AND
- 4. AT SECOND FLOOR WALL LOCATIONS WITH PARALLEL FLOOR JOIST/TRUSSES PROVIDE 2 X BLOCKING FULL DEPTH OF FLOOR

# 2. INTERIOR STUD WALL - 2 X 4 WOOD STUDS AT 16" O.C. WITH 1/2" DRYWALL ON ALL FINISHED SURFACES - TYPICAL. 8. MAINTAIN 4" MINIMUM ELEVATION CHANGE BETWEEN GARAGE FLOOR & FINISHED FIRST FLOOR.

**EPCON** 

#### PREFABRICATED METAL FIREDOX UNIT HEARTH & HOME MODEL DV3132591 (OR SIMILAR), PROVIDE 6AS LINE, 6AS LOS SET AND SCREEN - ROUGH OPENING 31" WIDE X 34 3/4" HIGH X 18" DEEP (26" DEEP WITH BUILT-IN CABINETRY OPTION). 6'-8 1/2" 6'-3 1/2" 2'-8" 18'-8" 5'-6" II. WASHER LOCATION - PROVIDE WASHER BOX ON BACK WALL. WASHER ALMAYS LOCATED LEFT OF DRYER 12. DRYER LOCATION - DRYER VENT IN WALL. 13. OPTIONAL UTILITY SINK AND FAUCET - INSTALL ROUGH-IN PLUMING ONLY. 4. SINGLE CLOSET ROD & SHELF (6T I/2" A.F.F.) - VINYL COATED WIRE MITH STANDARD SPACING, VERIFY HEIGHT IN SECOND FLOOR KNEE WALL AREAS. 15. ARCHED OPENING. SPRING POINT & 1'-6" A.F.F. TOP OF ARCH 8'-6" ABOVE SPRING POINT 6'-0" PATIO 16. LOCATION OF DOUBLE 2 X 4 STUD WALL. <del>4</del> BEDROOM 2 S IT. FRAMELESS MIRROR LOCATION - 42' HIGH $\times$ 2' SHORTER THAN VANITY TOP (I" EACH SIDE) - SET BOTTOM OF MIRROR AT TOP OF BACKSPLASH. FIREPLACE TO ALWAYS BE BUILT WITH THE BONUS ROOM OPTION AND EXTENDED LIVING ROOM. -<del>46</del> 18. VANITY BASE AND COUNTERTOP 31 1/2" A.F.F. (E.) LIVING K ROOM A401 20 SELE-RIMMING COUNTER LAVATORY AND FAILER 21. 32" X 60" STANDARD TUB/SHOWER & FAUCET WITH CERAMIC TILE SURROUND (3) (5I)— 22. TEMPERED GLASS SHOWER ENCLOSURE AND DOOR. 9 |6" O.C. 2 X |O F.J. (DOUBLED) 29. 25 $1/2^{\circ}$ x 54 ' OPTIONAL FILL DOWN STAIR LOCATED BETWEEN TRUSSES ABOVE. DRIVIALL ON STAIR SHALL BE MOANTED WITH SOREMS INTO THE TOP 4 BOTTOM DOOR CROSS SUPPORTS WITH THE CENTER GLIED LEAVING NO SOREMS ENDOSED. NOTE: NO TRAY CEILING IN 5-0 x 8-6 DMO.—— KITCHEN OR LIVING ROOM WITH BONUS ROOM OPTION 2'-0" | TYP. 24. BASE CABINETS AND COUNTERTOP. 25. LINE OF WALL CABINETS ABOVE.

8'-0" (3) 1-3/4" x 16" LVL BEAM FLUSH KITCHEN

2 X 6 C.J 30 (3) 5'-3" 48

4'-0" DRYWALL CEILING IN GARAGE WITH BONUS ROOM LVL BEAM

|8'-0" DOOR

OPTION:

(2) |-3/4" |8" LVL

T3. ATTIC ACCESS PANEL: 22° x 80° MINIMIM. PANEL TO BE 6° MIN ABOVE BASE IF LOCATED IN KINE MALL. PANEL TO HAVE IF GUARTER ROUND MOUDING AROUND EDGE. PANEL SHALL BE WEATHER-STRIPPED AND MOULTING TO A LEVEL EQUIVALENT TO THE INSULATION ON THE SURROUNDING SURFACES. IF IN THE CELLING, A BAFFLE IS REQUIRED TO CONTAIN LOOSE-FILL INSULATION.

16. 2 x 6 HALF WALL @ 36" A.F.F. WITH I X 8 HARDWOOD CAP - 1/2" LAG BOLT EACH END THRU SUB FLOOR.

TT. SINGLE CLOSET ROD & SHELF (48" A.F.F.) - VINYL COATED WIRE WITH STANDARD SPACING.

19. 3" DIAMETER STANDARD STEEL PIPE COLUMN WITH I/2" CAP PLATE AND I/2" x 4" x 6" BASE PLATE.

14. UNDER THE COUNTER REPRIGERATOR LOCATION

80. FULL HEIGHT PANTRY CABINET - SEE INTERIOR ELEVATIONS.

82. LINE INDICATES EXPOSED FOUNDATION STEM WALL.

88. FLAT DRYWALL CEILING # 8'-4" AFF...

81. DASHED LINE INDICATES BEAM - SEE BONJS ROOM GARAGE WALL SECTION.

84. DASHED LINE INDICATES 8" CEILING SOFFIT FOR SANITARY LINES FROM BONUS ROOM

15. FLAT DRYWALL CEILING # 7'-O' A.F.F.,

31.  $16^{\circ}$ O'  $\times$   $\delta^{\circ}$ O' optional attic storage above - provide 3/4" apa rated sub-flooring on bottom chord of trusses.

28. DOUBLE BOWL SINK AND FAILE 29. RANGE LOCATION.

32. TOILET PAPER DISPENSER

34. FURNACE LOCATION.

FIRST FLOOR PLAN CODED NOTES

(FIRST FLOOR UNIT PLANS ONLY) (ALL NOTES NOT APPLICABLE TO ALL SHEETS)

I. EXTERIOR STUD WALL -  $2\times4$  wood studs at 16° o.c. with 1/2° drywall on all interior surfaces and 7/16° o.s.b. Sheathing on exterior surfaces - typical.

3. FLAT DRYWALL CEILING # 4'-0' A.F.F. - TYPICAL UNLESS NOTED OTHERWISE

4. 20" DEEP X 60" WIDE GRANITE HEARTH EXTENSION - CENTERED ON FIREBOX.

1. PROVIDE FIBERGLASS BATT INSULATION IN GARAGE WALLS COMMON TO LIVING SPACE.

40. SURFACE MOUNTED ELECTRIC PANEL LOCATION

41. PROVIDE (2) JACKS UNDER ALL HEADERS IN OPENINGS OVER 60" WIDE - TYPICAL

42. INDICATES MULTIPLE STUD COLUMN IN WALL - TYPICAL AT BEARING OF ALL WOOD BEAMS, GIRDER TRUSGES UNLESS NOTED OTHERWISE. SEE PLAN FOR NUMBER OF STUDS REQUIRED.

38. (4) 16" DEEP WIRE SHELVES (24", 42", 55", 66" A.F.F.) - STANDARD SPACING. TYPICAL AT LINEN CLOSETS

36.  $10^{\circ}$  X  $10^{\circ}$  BUILT-UP COLUMN / PILASTER - TYPICAL. SEE DETAIL F, SHEET A 304 FOR MORE INFORMATION.

45. CUSTOM TILED WALK-IN SHOWER BASE - SEE PLAN FOR SIZE.

46. WOOD GUARD RAIL (OPTIONAL) - SEE DETAIL K ON SHEET A 304.

47. TILED CORNER SEAT OPTION - 30" WIDE X 18" A.F.F. HIGH.

49. FLAT DRYWALL CEILING @ 8'-4" A.F.F.

50. SOAP DISH - 5" HIGH X 7" WIDE.

51. DOWNSPOUT LOCATION

54. 4" THICK SLAB TYPICAL & CONCRETE WALKS/PORCHES/PATIOS

55. CONTROL JOINTS - TYPICAL

56. DASHED LINES INDICATE BOXED BEAM ABOVE. 57. 12" DEEP SHELF (60" A.F.F.) - VINYL COATED WIRE - STANDARD SPACING

58. SHOWER WALL - 6'-0" A.F.F.

59. OPTIONAL GARAGE SHELVING.

60. OPTIONAL DESK.

62. DASHED LINE INDICATES OPTIONAL PATIO SECTION

64. (4) 12" DEEP WIRE SHELVES (24", 42", 55", 68" A.F.F.) - STANDARD SPACING

65. 32" X 60" SHOWER BASE WITH BUILT-IN SEAT

67. WOOD HANDRAIL - 34" ABOVE STAIR TREADS. RETURN ENDS TO WALL OR NEWEL POST.

# Foundation Development Broup, LLC & Bel Haven, LLC Bel Haven Beckett Road West Chester, Ohio 45069 $\exists$ Group, I

O

#### PROPRIETARY RIGHTS NOTICE COPYRIGHT 2007 EPCON COMMUNITIES FRANCHIS

Prototype Disk No.	Interim Page Revisions	
Disk Ño.	Revision	Date
		4/28/10
		4/28/10


Architect Project Number 2019-044

Community Dates & Revisions 20 FEB 2020

> Drawing Title First Floor Plan


Architectural Style **European Country** 

Sheet Number A.101

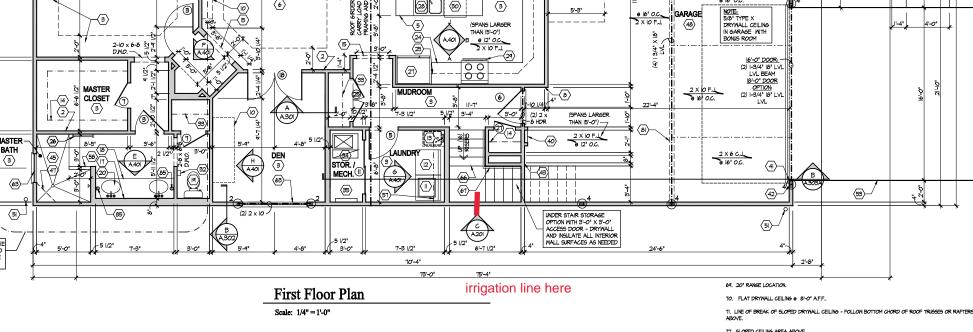

#### GENERAL NOTES

- I. EXTERIOR WALL DIMENSIONS INCLUDE THICKNESS OF SHEATHING.
- 2. REFER TO SITE LAYOUT PLAN FOR BUILDING LOCATIONS AND ORIENTATIONS.
- 3. DOORS NOT OTHERWISE DIMENSIONED SHALL BE LOCATED WITH ROUGH OPENING 3" FROM INTERSECTING WALLS.

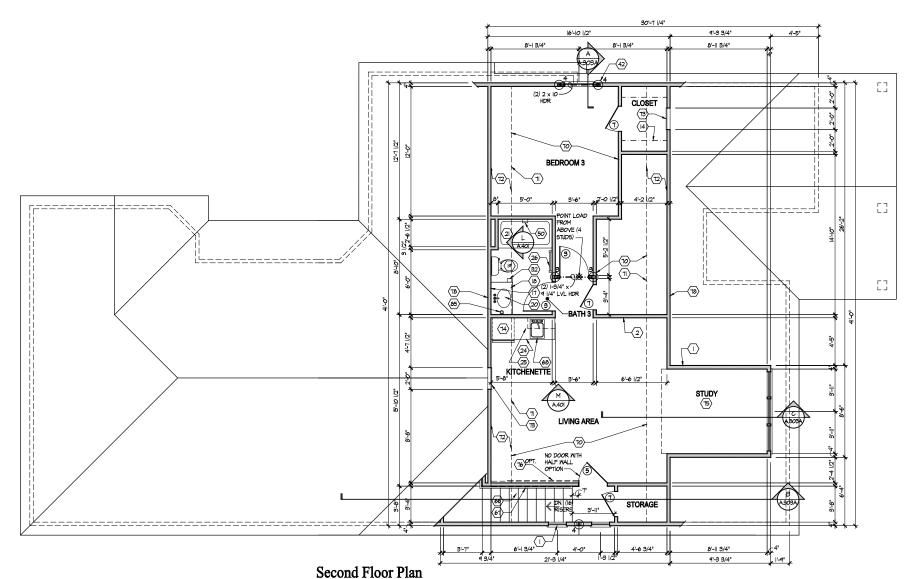

Scale: 1/4" = 1'-0"

- 69. 20' RANGE LOCATION.
- TO. FLAT DRYWALL CEILING @ 8'-0" AFF ...
- 11. LINE OF BREAK OF SLOPED DRYWALL CEILING FOLLOW BOTTOM CHORD OF ROOF TRUSSES OR RAFTERS ABOVE.
- 12. SLOPED CEILING AREA ABOVE.
- T3. ATTIC ACCESS PANEL: 22° x 80° MINIMUM. PANEL TO BE 6° MIN ABOVE BASE IF LOCATED IN KNEE WALL. PANEL TO HAVE I" GUARTER ROUND MOUDING AROUND EDGE. PANEL SHALL BE WEATHER-GISIPPED AND INSLATED TO A LEVEL BOUNDART TO THE INSLATION ON THE SURROUNDING SURFACES. IF IN THE CEILING, A BAFFLE IS REGUIRED TO CONTAIN LOOSE-FILL INSULATION.
- 14. UNDER THE COUNTER REPRIGERATOR LOCATION
- 15. FLAT DRYWALL CEILING & 7'-O' A.F.F.,
- 16. 2 x 6 HALF WALL & 36" A.F.F. WITH I X 8 HARDWOOD CAP 1/2" LAG BOLT EACH END THRU SUB FLOOR.
- T1. SINGLE CLOSET ROD & SHELF (48" A.F.F.) VINYL COATED WIRE WITH STANDARD SPACING.
- 18. KNEE WALL:  $2\times4$  MOOD STUDS AT 16° OC. NTH 1/2° DRYWALL ON ALL INTERIOR SURFACES, AND 1/4° OSB BACKER PANEL ON EXTERIOR SURFACES TYPICAL. RIAI FROM FLOOR STRUCTURE BELOW TO UNDERSIDE OF FOOT FRANNIS.
- 19. 3" DIAMETER STANDARD STEEL PIPE COLUMN WITH 1/2" CAP PLATE AND 1/2" x 4" x 6" BASE PLATE.
- 80. FULL HEIGHT PANTRY CABINET SEE INTERIOR ELEVATIONS
- 81. DASHED LINE INDICATES BEAM SEE BONUS ROOM GARAGE WALL SECTION.
- 82. LINE INDICATES EXPOSED FOUNDATION STEM WALL.
- 88. FLAT DRYWALL CEILING # 8'-4" A.F.F.
- 84. DASHED LINE INDICATES 8" CEILING SOFFIT FOR SANITARY LINES FROM BONUS ROOM.
- 85. TOWEL RING.

#### FIRST FLOOR PLAN CODED NOTES (FIRST FLOOR WIT PLANS ONLY)


- (ALL NOTES NOT APPLICABLE TO ALL SHEETS)
- I. EXTERIOR STUD WALL  $2\times4$  Wood STUDS AT 16" O.C. WITH 1/2" DRYWALL ON ALL INTERIOR SURFACES AND 7/16" O.S.B. SHEATHING ON EXTERIOR SURFACES TYPICAL.
- 2. INTERIOR STUD WALL -2 X 4 WOOD STUDS AT 16" O.C. WITH 1/2" DRYWALL ON ALL FINISHED SURFACES -
- 3. FLAT DRYWALL CEILING . 9'-0" A.F.F. TYPICAL UNLESS NOTED OTHERWISE.
- 4. 20" DEEP X 60" WIDE GRANITE HEARTH EXTENSION CENTERED ON FIREBOX.
- 5. ISLAND BASE CABINETS & COUNTERTOP FINISH ALL EDGES OF CABINETS & COUNTERTOF
- 7. PROVIDE FIBERGLASS BATT INSULATION IN GARAGE WALLS COMMON TO LIVING SPACE.
- 8. MAINTAIN 4" MINIMUM ELEVATION CHANGE BETWEEN GARAGE FLOOR & FINISHED FIRST FLOOR.
- 9. PREFABRICATED METAL FIREBOX UNIT HEARTH \$ HOME MODEL DY91829BI (OR SIMILAR), PROVIDE 6AS LINE, 6AS LOG SET AND SCREEN ROUGH OPENING 91" MIDE  $\times$  34 3/4" HIGH  $\times$  18" DEEP (26" DEEP WITH BUILT-IN CABINETRY OPTION).
- IO. OPTIONAL CABINETS SEE INTERIOR ELEVATIONS.
- II. WASHER LOCATION PROVIDE WASHER BOX ON BACK WALL, WASHER ALMAYS LOCATED LEFT OF DRYER.
- 12. DRYER LOCATION DRYER VENT IN WALL.
- 13. OPTIONAL UTILITY SINK AND FAICET INSTALL ROUGH-IN PLIMING ONLY.
- SINGLE CLOSET ROD & SHELF (6T 1/2" AFF.) VINYL COATED WIRE WITH STANDARD SPACING. VERIFY HEIGHT IN SECOND FLOOR KNEE WALL AREAG.
- 15. ARCHED OPENING. SPRING POINT @ 7'-8" A.F.F. TOP OF ARCH 8'-6" ABOVE SPRING POINT.
- 16. LOCATION OF DOUBLE 2 X 4 STUD WALL.
- IT. FRAMELESS MIRROR LOCATION  $42^{\circ}$  HIGH x  $2^{\circ}$  SHORTER THAN VANITY TOP (I\* EACH SIDE) SET BOTTOM OF MIRROR AT TOP OF BACKSPLASH.
- 16. VANITY BASE AND COUNTERTOP 31 1/2" A.F.F.
- IA. TOILET & SEAT
- 20. SELF-RIMMING COUNTER LAVATORY AND FAUCET.
- 21. 32" X 60" STANDARD TUB/SHOWER & FAUCET WITH CERAMIC TILE SURROUND.
- 22. TEMPERED GLASS SHOWER ENCLOSURE AND DOOR.
- 23, 25  $12^{\circ}$  x 54° optional full down stair located between trigges above. Drymall on stair shall be modified with screme into the top 4 bottom door cross supports with the center glied leaving no screme diprosed.
- 24. BASE CABINETS AND COUNTERTOP
- 25. LINE OF WALL CABINETS ABOVE.
- 26. 24" LONG TOWEL BAR 54" A.F.F. (58" A.F.F. ABOVE TOILET).
- 28. DOUBLE BOWL SINK AND FAUCET.
- 29. RANGE LOCATION.
- 30. DISHWASHER LOCATION.
- 31. IO" X IO" BUILT-UP COLUMN TYPICAL SEE DETAIL D, SHEET A304 FOR MORE INFORMATION.
- 93. (4) 16" DEEP MIRE SHELVES (24", 42", 55", 66" A.F.F.) STANDARD SPACING, TYPICAL AT LINEN CLOSETS AND PANTRIES, UNLESS NOTED OTHERWISE.
- 34. FURNACE LOCATION
- 95. TANKLESS WATER HEATER LOCATION.
- 36. IO' X IO' BUILT-UP COLUMN / PILASTER TYPICAL, SEE DETAIL F, SHEET A304 FOR MORE INFORMATION.
- 31.  $16^{1}$ C' ×  $8^{1}$ C' Optional attic storage above Provide 3/4" apa rated sub-flooring on bottom chord of trusses.
- 38. I/2 WALL TO UNDERSIDE OF BAR COUNTERTOP
- 39. HOSE BIBB LOCATION.
- 40. SURFACE MOUNTED ELECTRIC PANEL LOCATION
- 42. INDICATES MILTIPLE STUD COLUMN IN MALL TYPICAL AT BEARING OF ALL WOOD BEAMS, GIRDER TRUSSES UNLESS NOTED OTHERWISE, SEE PLAN FOR NUMBER OF STUDS REQUIRED.

- 45. CUSTOM TILED WALK-IN SHOWER BASE SEE PLAN FOR SIZE.
- 46. MOOD GUARD RAIL (OPTIONAL) SEE DETAIL K ON SHEET A.304. 47. TILED CORNER SEAT OPTION - 30' WIDE X 18' A.F.F HIGH
- 46. FLAT DRYWALL CEILING ON UNDERSIDE OF BOTTOM CHORD OF ROOF TRUSSES OR FLOOR JOISTS.
- 50. SOAP DISH 5" HIGH X 7" MIDE.
- 51. DOWNSPOUT LOCATION.
- 52. DOWNSPOUT DISCHARGED INTO BLACK PIPE AND ROUTED UNDER WALKS OR PATIO.
- 54. 4" THICK SLAB TYPICAL & CONCRETE WALKS/PORCHES/PATIOS
- 55. CONTROL JOINTS TYPICAL.
- 56. DASHED LINES INDICATE BOXED BEAM ABOVE.
- 57. 12" DEEP SHELF (60" A.F.F.) VINYL COATED WIRE STANDARD SPACING.
- 54. OPTIONAL GARAGE SHELVING
- 60. OPTIONAL DESK.

63. OPTIONAL WINDOWS.

- 61. COURTYARD GATE AND FENCE LOCATION.
- 62. DASHED LINE INDICATES OPTIONAL PATIO SECTION.
- 64. (4) 12" DEEP WIRE SHELVES (24", 42", 55", 66" A.F.F.) STANDARD SPACING.
- 65. 32" X 60" SHOWER BASE WITH BUILT-IN SEAT.

- 66. HARDBOARD TREADS AND RISERS.
- 67. WOOD HANDRAIL 34" ABOVE STAIR TREADS. RETURN ENDS TO WALL OR NEWEL POST.
- 68. SINGLE BOWL SINK AND FAUCET.

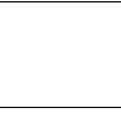



Where Life Comes Together

## FC indation Development, LLC & Bel Haven, LLC Bel Haven Beckett Road est Chester, Ohio 45069 Foundation roup, Ō

PROPRIETARY RIGHTS NOTICE COPYRIGHT 2007 EPCON COMMUNITIES FRANCHISING, INC.

	Prototype Disk No.	Interim Page Revisions		
		Revision	Date	
			4/28/10	


Architect Project Number


Community Dates & Revisions Date Originated 20 FEB 2020

Second Floor Plan


Architectural Style **European Country** Sheet Number

A.101A D2+ Bonus 2010

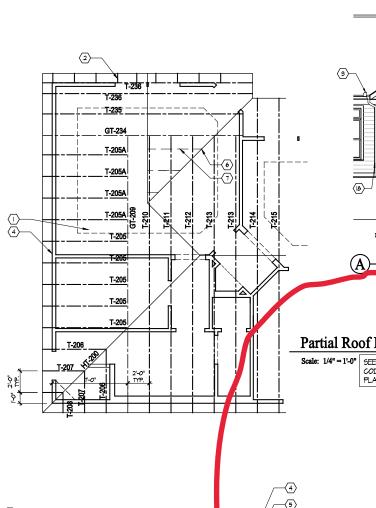


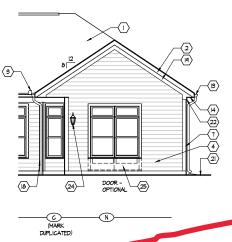



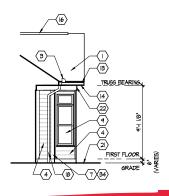



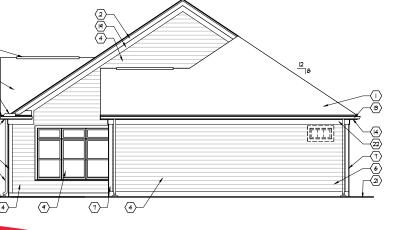



Partial Extended Master Scale: 3/16" = 1'-0" Suite Elevation

(MARK DUPLICATED)

Partial Extended Master Scale: 3/16" = 1'-0" Suite Elevation

SEE SHEET A 201 FOR ELEVATIONS. SEE BASE FLOOR PLAN FOR ELEVATION DESIGNATION MARKERS.

Foundation Development
Group, LLC & Bel Haven, LLC
Bel Haven
Beckett Road
West Chester, Ohio 45069

Architect Project Number 2019-044

┷ ┷


Community Dates & Revisions
Date Originated 20 FEB 2020 **Date Originated** 

**Deluxe Master Suite** Option

> Architectural Style European Country

Partial Roof Framing Plan


Scale: 1/4" = 1'-0" SEE SHEET S.IOI FOR ROOF FRAMING PLAN CODED NOTES AND BASE ROOF FRAMING PLAN & S.102 FOR ROOF TRUSS PROFILES.

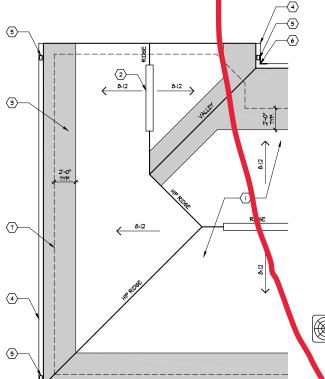




Scale: 1/4" = 1'-0"

SEE SHEET A.IO2 FOR ROOF PLAN CODED NOTES AND BASE ROOF PLAN.

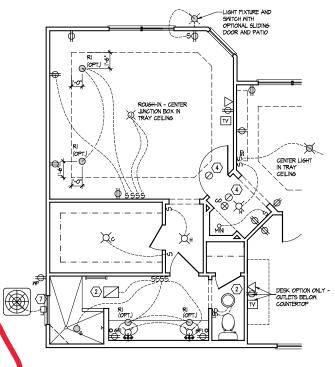

#### Electrical Plan - First Floor

SEE SHEET E.IOO FOR ELECTRICAL PLAN LEGEND AND BASE ELECTRICAL PLAN.

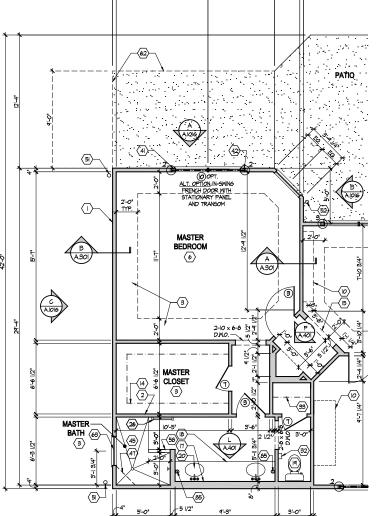

## Partial First Floor Plan

SEE SHEET A.IOI FOR PLAN CODED NOTES AND BASE FLOOR PLAN AND S.IO3, S.IO4 FOR SHEAR WALL INFO.

Scale: 1/4" = 1'-0"

Partial Foundation Plan Scale: 1/4" = 1'-0" SEE SHEET A.IOO FOR FOUNDATION CODED NOTES AND BASE FOUNDATION PLAN.

Sheet Number A.101G