# BUILDING TYPE Promenade (D3M Bonus - 2010)

# S. Bel Haven Ln., West Chester, OH 45069, Lot #06 Bel Haven

### **INDEX TO DRAWINGS**

### BUILDING D-3M BONUS

A.100 FOUNDATION PLAN A.101 FIRST FLOOR PLAN A.101A SECOND FLOOR PLAN A.101B COVERED PORCH OPTION A.101C SCREENED PORCH

A.101D SITTING ROOM OPTION

A.101E 4 SEASONS ROOM OPTION

- A.101F DELUXE MASTER SUITE PLANS & ELECTRICAL A.101G DELUXE MASTER SUITE ELEVATIONS & ROOF PLANS
- A.102 ROOF PLAN
- A.201 EXTERIOR ELEVATIONS
- S.101 ROOF FRAMING PLAN S.102 ROOF TRUSS PROFILES
- S.102A ROOF TRUSS PROFILES S.103 SHEAR WALL PLANS
- S.104 SHEAR WALL DETAILS
- A.301 WALL SECTIONS A.302 WALL SECTIONS A.303 WALL SECTIONS
- A.303A WALL SECTIONS A.304 DETAILS
- A.401 INTERIOR ELEVATIONS
- A.501 INTERIOR FINISH PLAN AND SCHEDULES
- A.502 WINDOW DETAILS A.503 WINDOW DETAILS
- P.100 PLUMBING PLANS
- SUPPLY PLUMBING PLAN
- P.102 PLUMBING SPECIFICATIONS AND SCHEDULES
- H.100 HVAC PLANS H.101 HVAC SCHEDULES & DETAILS
- E.100 ELECTRICAL PLAN
- E.101 ELECTRICAL PLAN AND DETAILS DELUXE KITCHEN

### **GENERAL NOTES**

- 1. ALL WORK, SHALL COMPLY WITH APPLICABLE STATE AND LOCAL BUILDING CODES AND THE BUILDING STANDARDS REFERENCED THEREIN.
- 2. ALL WORK SHALL CONFORM TO THE HIGHEST LEVELS OF THE APPROPRIATE INDUSTRY STANDARDS FOR CUSTOM WORK.
- 3. ALL WORK TO BE COORDINATED AND SCHEDULED BY THE OWNER.
- 4. FRAMING LUMBER IN CONTACT WITH CONCRETE OR MASONRY, OR EXPOSED TO THE EXTERIOR SHALL BE PRESERVATIVE PRESSURE TREATED.
- 5. PLAN DIMENSIONS ARE TO FACE OF ROUGH FRAMING OR MASONRY UNLESS NOTED OTHERWISE. DIMENSIONS TO EXTERIOR WALLS INCLUDE 7/16" EXT. SHEATHING, ROUNDED TO THE NEAREST 1/4".
- 6. FINISH FLOOR ELEV. @ FIRST FLOOR LEVEL IS SET AT 100'-0". SEE SITE PLAN FOR ACTUAL FIRST FLOOR ELEVATION @ EACH BUILDING.
- 7. ALL INTERIOR PARTITIONS SHALL BE 2 x 4 STUDS @ 16" O.C. WITH 1/2" DRYWALL EACH SIDE. PLAN DIMENSION IS ASSUMED TO BE 3 1/2" UNLESS NOTED OTHERWISE. PROVIDE SOLID LUMBER BLOCKING FOR ALL WALL MOUNTED ITEMS.
- 8. ALL DRYWALL IN WET AREAS, AND AS A SUBSTRATE FOR TILE, SHALL BE MOISTURE RESISTANT 1/2" WATERBOARD OR GREENBOARD.
- 9. ALL INTERIOR COLORS AND FINISHES, NOT SPECIFIED HEREIN, TO BE SELECTED BY THE

# **EPCON** Communities

Where Life Comes Together

Bel Haven, LLC (513) 868-9800

### CODE REVIEW INFORMATION

PERFORMANCE APPROACH

**GOVERNING BUILDING CODE:** 2019 RESIDENTIAL CODE OF OHIO CHAPTER 11 (ENERGY EFFICIENCY): COMPLIANCE PATH 2 - SIMULATED

**CONSTRUCTION TYPE:** WOOD FRAME

**NUMBER OF STORIES:** 2 STORY

2,487 SF TOTAL AREA - FIRST FLOOR **BUILDING AREAS:** 

### GENERAL BUILDING INFORMATION

THIS BUILDING IS A  $\,$  (1) UNIT SINGLE FAMILY DWELLING STRUCTURE. THE DWELLING UNIT CONTAINS:

2,009 SF OF FIRST FLOOR, 478 SF GARAGE AND 760 SF SECOND FLOOR LIVING SPACE IN EACH UNIT. TOTAL = 3,247 SF. THE TYPE D-3M BONUS UNIT IS A TWO STORY DESIGN.

THE OPTIONS BELOW WILL EACH ADD THE FOLLOWING SQUARE

SITTING ROOM - 105 SF **EXTENDED MASTER SUITE - 189 SF** 

### GENERAL SPECIFICATIONS

### THE STRUCTURE IS DESIGNED TO BE SELF-SUPPORTING AND STABLE AFTER THE BUILDING IS FULLY COMPLETE. IT IS

- SOLELY THE CONTRACTORS RESPONSIBILITY TO INSURE THE SAFETY OF THE BUILDING AND ITS COMPONENT PARTS DURING ERECTION. THIS INCLUDES THE ADDITION OF TEMPORARY BRACING OR GUYS THAT MIGHT BE NECESSARY.
- 2. IT IS SOLELY THE CONTRACTOR'S RESPONSIBILITY TO FOLLOW ALL APPLICABLE SAFETY CODES AND REGULATIONS DURING ALL PHASES OF CONSTRUCTION.
- 3. THIS STRUCTURE IS DESIGNED TO RESIST THE FOLLOWING MINIMUM UNIFORMLY DISTRIBUTED LIVE LOADS: ATTICS WITHOUT STORAGE
- ATTICS WITH LIMITED STORAGE 20 PSF 30 PSF HABITABLE ATTICS ATTICS WITH FIXED STAIRS 30 PSF 40 PSF BALCONIES & DECKS ROOMS OTHER THAN SLEEPING ROOMS 30 PSF
- SLEEPING ROOMS 40 PSF 25 PSF (GROUND SNOW LOAD) CEILING JOISTS (HIGH SLOPE RAFTERS)
- CEILING JOISTS (LOW SLOPE/NO STORAGE) IO PSF Vult 115 MPH, Vasa 89 MPH, EXP. B

### I. STRUCTURAL CONCRETE:

- F'C = 3000 PSI FOOTINGS, INTERIOR SLABS
- EXPOSED WALLS, GARAGE SLABS AND EXTERIOR SLABS ON GRADE F'C = 4000 PSI (5%-7% ENTRAINED AIR) ALL DEFORMED REINFORCING BARS FY = 60,000 PSI
- 2. CONCRETE TO BE MIXED AND PLACED PER ACI SPECIFICATIONS.

- MASONRY VENEER SHALL BE ANCHORED TO THE SUPPORTING WALL WITH CORROSION-RESISTANT METAL TIES EMBEDDED IN MORTAR OR GROUT, AND EXTENDING INTO THE VENEER A MINIMUM OF I-I/2", WITH NOT LESS THAN 5/8"MORTAR OR GROUT COVER TO OUTSIDE FACE.
- 2. WHERE VENEER IS ANCHORED TO WOOD BACKINGS BY CORRUGATED SHEET METAL TIES, THE DISTANCE SEPARATING THE VENEER FROM THE SHEATHING MATERIAL SHALL BE A MAXIMUM OF I".
- 3. SHEET METAL TIES SHALL BE NOT LESS THAN NO. 22 U.S. GAGE BY 7/8" CORRUGATED. EACH TIE SHALL BE SPACED NOT MORE THAN 24" ON CENTER HORIZONTALLY AND VERTICALLY, AND SHALL SUPPORT NOT MORE THAN 2.67 SF OF
- 4. ADDITIONAL TIES SHALL BE PROVIDED AROUND ALL WALL OPENINGS GREATER THAN 16" IN EITHER DIMENSION. METAL TIES AROUND THE PERIMETER OF OPENINGS SHALL BE SPACED NOT MORE THAN 3'-O" O.C., AND PLACED WITHIN 12" OF THE WALL OPENING.

- I. VINYL SIDING SHALL BE CERTIFIED AND LABELED AS CONFORMING TO THE REQUIREMENTS OF ASTM D 3679 BY AN APPROVED QUALITY CONTROL AGENCY.
- 2. VINYL SIDING, SOFFIT, AND ACCESSORIES SHALL BE INSTALLED IN ACCORDANCE WITH THE MANUFACTURER'S INSTALLATION INSTRUCTIONS.
- 3. SOFFIT PANELS SHALL BE INDIVIDUALLY FASTENED TO A SUPPORTING COMPONENT SUCH AS A NAILING STRIP, FASCIA, OR SUBFASCIA COMPONENT, OR AS SPECIFIED BY THE MANUFACTURER.

### ASPHALT SHINGLES

SHINGLE PACKAGING SHALL BEAR A LABEL TO INDICATE COMPLIANCE TO:

ASPHALT SHINGLES SHALL BE TESTED IN ACCORDANCE WITH ASTM D 7158. SHINGLES SHALL MEET THE CLASSIFICATION REQUIREMENTS FOR THE APPROPRIATE MAXIMUM BASIC WIND SPEED:

MAXIMUM BASIC WIND SPEED CLASSIFICATION REQUIREMENT PER ASTM D 7158 D, GORH

100 MPH G OR H G OR H

### STRUCTURAL LUMBER JOISTS, BEAMS, RAFTERS, AND 2 x 6 STUDS ARE TO BE A MINIMUM GRADE OF SPRUCE-PINE-FIR (SOUTH) NO. 2, WITH

- THE FOLLOWING MINIMUM PROPERTIES: FB = 750 PSI
- FV = 70 PSI FC = 335 PSI (PERPENDICULAR)
- FC = 975 PSI (PARALLEL)
- E = 1,000,000 PSI
- $2.2 \times 4$  STUDS, UNLESS NOTED OTHERWISE, ARE TO BE A MINIMUM GRADE OF HEM-FIR STUD GRADE, WITH THE
- FOLLOWING MINIMUM PROPERTIES: FB = 675 PSI FT
- FV = 75 PSI
- FC = 405 PSI (PERPENDICULAR) FC = 800 PSI

E = 1,200,000 PSI

- 3. LAMINATED VENEER LUMBER (LVL) SHALL BE "I.9 E MICROLAM LVL" AS MANUFACTURED BY TRUS JOIST MACMILLAN
  - (OR EQUAL), WITH THE FOLLOWING DESIGN PROPERTIES: FB = 2,800 PSI (SINGLE 12" MEMBER)
  - FV = 285 PSI
  - FC = 750 PSI (PERPENDICULAR)
  - FC = 2000 PSI (PARALLEL TO GRAIN) E = 1,900,000 PSI
- 4. UNLESS SPECIFICALLY SHOWN OTHERWISE, DESIGN, FABRICATION AND ERECTION SHALL BE GOVERNED BY THE LATEST REVISIONS OF:
- NATIONAL DESIGN SPECIFICATION FOR WOOD CONSTRUCTION PRODUCT STANDARD PS-I-83 FOR CONSTRUCTION AND INDUSTRIAL PLYWOOD
- APA PRP-108 FOR STRUCTURAL USE PANELS, OR PS\_2-92 FOR WOOD-BASED STRUCTURAL USE PANELS APA RESIDENTIAL CONSTRUCTION GUIDE
- 5. TRUSSES, STRUCTURAL COMPOSITE LUMBER, STRUCTURAL GLUE-LAMINATED MEMBERS, AND I-JOISTS SHALL BE SUPPORTED LATERALLY AS REQUIRED BY THE MANUFACTURER.
- 6. ANY DRILLING OR NOTCHING OF THE WALL DOUBLE TOP PLATES SHALL BE IN COMPLIANCE WITH THE BUILDING CODE.

- I. USE ONE LINE OF SOLID BLOCKING OR CROSS BRIDGING AT 8'-O" O/C FOR CEILING JOISTS. USE SOLID BLOCKING
- 2. USE ONE CRIPPLE STUD AND ONE FULL HEIGHT STUD UNDER BEAM AND HEADER BEARING LESS THAN 4'-O AND ONE CRIPPLE STUD AND TWO FULL HEIGHT STUDS UNDER BEAM AND HEADER BEARING 4'-O OR GREATER, UNLESS SHOWN
- 3. APPLY CONTINUOUS BEAD OF GLUE ON JOISTS AND GROOVE OF TONGUE-AND-GROOVE PANELS.
- 4. BUILDING ENVELOPE AIR TIGHTNESS AND INSULATION INSTALLATION SHALL BE DEMONSTRATED TO COMPLY WITH ONE OF THE FOLLOWING OPTIONS:
- TESTING OPTION: TESTED AIR LEAKAGE WITH A BLOWER DOOR TEST B. VISUAL INSPECTION OPTION: INSPECTION OF ITEMS LISTED IN TABLE 1102.4.2. (SEE MECHANICAL DRAWINGS FOR ADDITIONAL INFORMATION)
- 5. FRAMING LUMBER IN CONTACT WITH CONCRETE OR MASONRY, OR EXPOSED TO THE EXTERIOR SHALL BE PRESERVATIVE PRESSURE TREATED.
- 6. ANY WOOD, INCLUDING EXTERIOR SHEATHING, WITHIN 6" OF FINISHED GRADE SHALL BE PRESERVATIVE-PRESSURE
- 7. WALL COVERINGS, BACKING MATERIALS, AND THEIR ATTACHMENTS SHALL BE CAPABLE OF RESISTING WIND LOADS IN ACCORDANCE WITH THE FOLLOWING TABLES: A. SEISMIC DESIGN CATEGORIES
- B. WEATHERING PROBABILITY MAP FOR CONCRETE
- 7. AN APPROVED WATER-RESISTIVE BARRIER SHALL BE APPLIED OVER SHEATHING OF ALL EXTERIOR WALLS. SUCH MATERIAL SHALL BE APPLIED HORIZONTALLY, WITH THE UPPER LAYER LAPPED OVER THE LOWER LAYER NOT LESS THAN 2". WHERE JOINTS OCCUR, BARRIER SHALL BE LAPPED NOT LESS THAN 6". THE BARRIER SHALL BE CONTINUOUS TO THE TOP OF THE WALL, AND TERMINATED AT PENETRATIONS AND BUILDING APPENDAGES IN A MANNER TO MEET THE REQUIREMENTS OF THE EXTERIOR WALL ENVELOPE.
- 9. OPTION: THE SPECIFIED 1/16" EXTERIOR SHEATHING CAN BE SUBSTITUTED FOR I" ZIP SYSTEM "R-SHEATHING".

### STRUCTURAL STEEL

I. ANCHOR BOLTS AND OTHER BOLTS EXCEPT AS MAY BE NOTED: ASTM A307.

- 2. STRUCTURAL STEEL TO BE ASTM A36 WITH A SHOP COAT OF RUST-INHIBITIVE PAINT, EXCEPT FOR CORROSION-RESISTANT STEEL, AND STEEL TREATED WITH COATINGS TO PROVIDE CORROSION RESISTANCE.
- 3. STEEL BELOW GRADE TO BE PROTECTED BY A MINIMUM OF 3" OF CONCRETE OR 4" OF MASONRY
- 4. COLUMNS SHALL BE RESTRAINED TO PREVENT LATERAL DISPLACEMENT AT THE BOTTOM END. COLUMNS SHALL NOT BE LESS THAN 3" DIAMETER, SCHEDULE 40 PIPE, MANUFACTURED IN ACCORDANCE WITH ASTM A 53 GRADE B, OR APPROVED EQUIVALENT.
- 5. STEEL LINTELS SHALL BE SHOP COATED WITH A RUST-INHIBITIVE PAINT, EXCEPT FOR LINTELS MADE OF CORROSION-RESISTANT STEEL, OR STEEL TREATED WITH COATINGS TO PROVIDE CORROSION RESISTANCE. THE ALLOWABLE SPAN SHALL NOT EXCEED THE FOLLOWING VALUES, WITH THE LONG LEG OF THE ANGLE IN THE VERTICAL

ANGLE SIZE	NO STORY ABOVE	ONE STORY ABOY
3" X 3" X I/4"	6'-0"	4'-6"
4" X 3" X I/4"	8'-0"	6'-0"
5" X 3-1/2" X 5/16"	10'-0"	&' <b>-</b> O"
6" X 3-1/2" X 5/16"	14"-0"	9'-6"

### CONNECTIONS & FASTENERS

I. JOISTS TO BEAMS OR JOISTS TO TRUSSES - 16 GA. STD. JOIST HANGERS, UNLESS SHOWN OTHERWISE - AS

- 2. ROOF TRUSSES TO SUPPORTING TOP PLATES OR BEAMS USE HURRICANE TIES, EQUAL TO SIMPSON H3, WITH ALL
- NAIL HOLES FILLED; ONE PER TRUSS END. 3. ROOF SHEATHING TO JOISTS/TRUSSES:- USE 8D NAILS AT 6" O/C AT PANEL EDGES AND 12" O/C AT INTERMEDIATE
- 4. FASTENERS AND CONNECTORS IN CONTACT WITH PRESERVATIVE-TREATED WOOD AND FIRE-RETARDANT-TREATED WOOD SHALL BE OF: HOT DIPPED ZING-COATED GALVANIZED STEEL
  - STAINLESS STEEL SILICON BRONZE COPPER

### TRUSS NOTES I. LUMBER AS REQUIRED BY THE TRUSS MANUFACTURER, MINIMUM GRADE TO BE SYP NO. 2, KD 15 PERCENT MC.

- 2. CONNECTIONS: ALL INTERNAL TRUSS CONNECTIONS ARE TO BE DESIGNED BY THE TRUSS MANUFACTURER. CONNECTORS SHALL BE DEFORMED PLATE TYPE, OF MINIMUM 20 GAUGE GALVANIZED STEEL SHEET. ALL JOINTS ARE TO BE DESIGNED USING METHODS AS SET FORTH IN TPI STANDARDS 1976.
- 3. HANGERS: ALL TRUSS TO TRUSS HANGERS ARE TO BE DESIGNED AND SUPPLIED BY THE TRUSS SUPPLIER.
- 4. SPECIFICATIONS AND REFERENCE STANDARDS: UNLESS SPECIFICALLY SHOWN OTHERWISE, DESIGN, FABRICATION, ERECTION, HANDLING AND BRACING REQUIREMENTS ARE TO BE GOVERNED BY THE LATEST REVISIONS OF: NATIONAL DESIGN SPECIFICATIONS FOR STRESS-GRADE LUMBER AND ITS FASTENINGS TIMBER CONSTRUCTION STANDARDS
- TRUSS PLATE INSTITUTE PUBLICATION-BTW BRACING WOOD TRUSSES: COMMENTARY AND RECOMMENDATIONS 5. ALL TRUSSES ARE TO BE DESIGNED BY THE TRUSS MANUFACTURER FOR THE FOLLOWING LOADS:

DESIGN SPECIFICATIONS FOR LIGHT METAL PLATE CONNECTED WOOD TRUSSES

TRUSS DESIGN DRAWINGS SHALL BE STAMPED BY A REGISTERED ENGINEER


- 25 PSF (GROUND SNOW) TOP CHORD LIVE LOAD: DEAD LOAD: BOTTOM CHORD LIVE LOAD: 10 PSF
- 6. WHERE TRUSSES ARE REQUIRED TO FRAME INTO OTHER TRUSSES, THE DESIGN OF THE HANGERS SHALL BE THE RESPONSIBILITY OF THE TRUSS SUPPLIER. THIS IS TO INCLUDE THE DESIGN OF THE HANGERS AND PROVISION IN THE SUPPORTING TRUSS TO ACCEPT THE TYPE OF HANGER PROVIDED.
- 7. TRUSS DESIGNS ARE TO BE SUBMITTED FOR REVIEW PRIOR TO FABRICATION. TRUSS SUBMITTAL SHALL INCLUDE THE FOLLOWING INFORMATION: DESIGN INFORMATION FOR EACH TYPE OF TRUSS SUPPLIED TRUSS HANGER TYPE AND LOCATION, FOR ALL TRUSSES FRAMING INTO TRUSSES
- 8. ALL MEMBERS OF MULTIPLE TRUSSES ARE TO BE NAILED TOGETHER WITH IOD COMMON NAILS AT 8" O.C., FOR DOUBLE TRUSSES, OR WITH 16D COMMON NAILS AT 8" O.C. FROM EACH SIDE, FOR TRIPLE TRUSSES.

## DEAN A. WENZ

## ARCHITECTS


2463 E. Main Street, Bexley, Ohio 43209 (614) 239-6868 www.wenz-architects.com


### Gas Furance, heater and fireplace

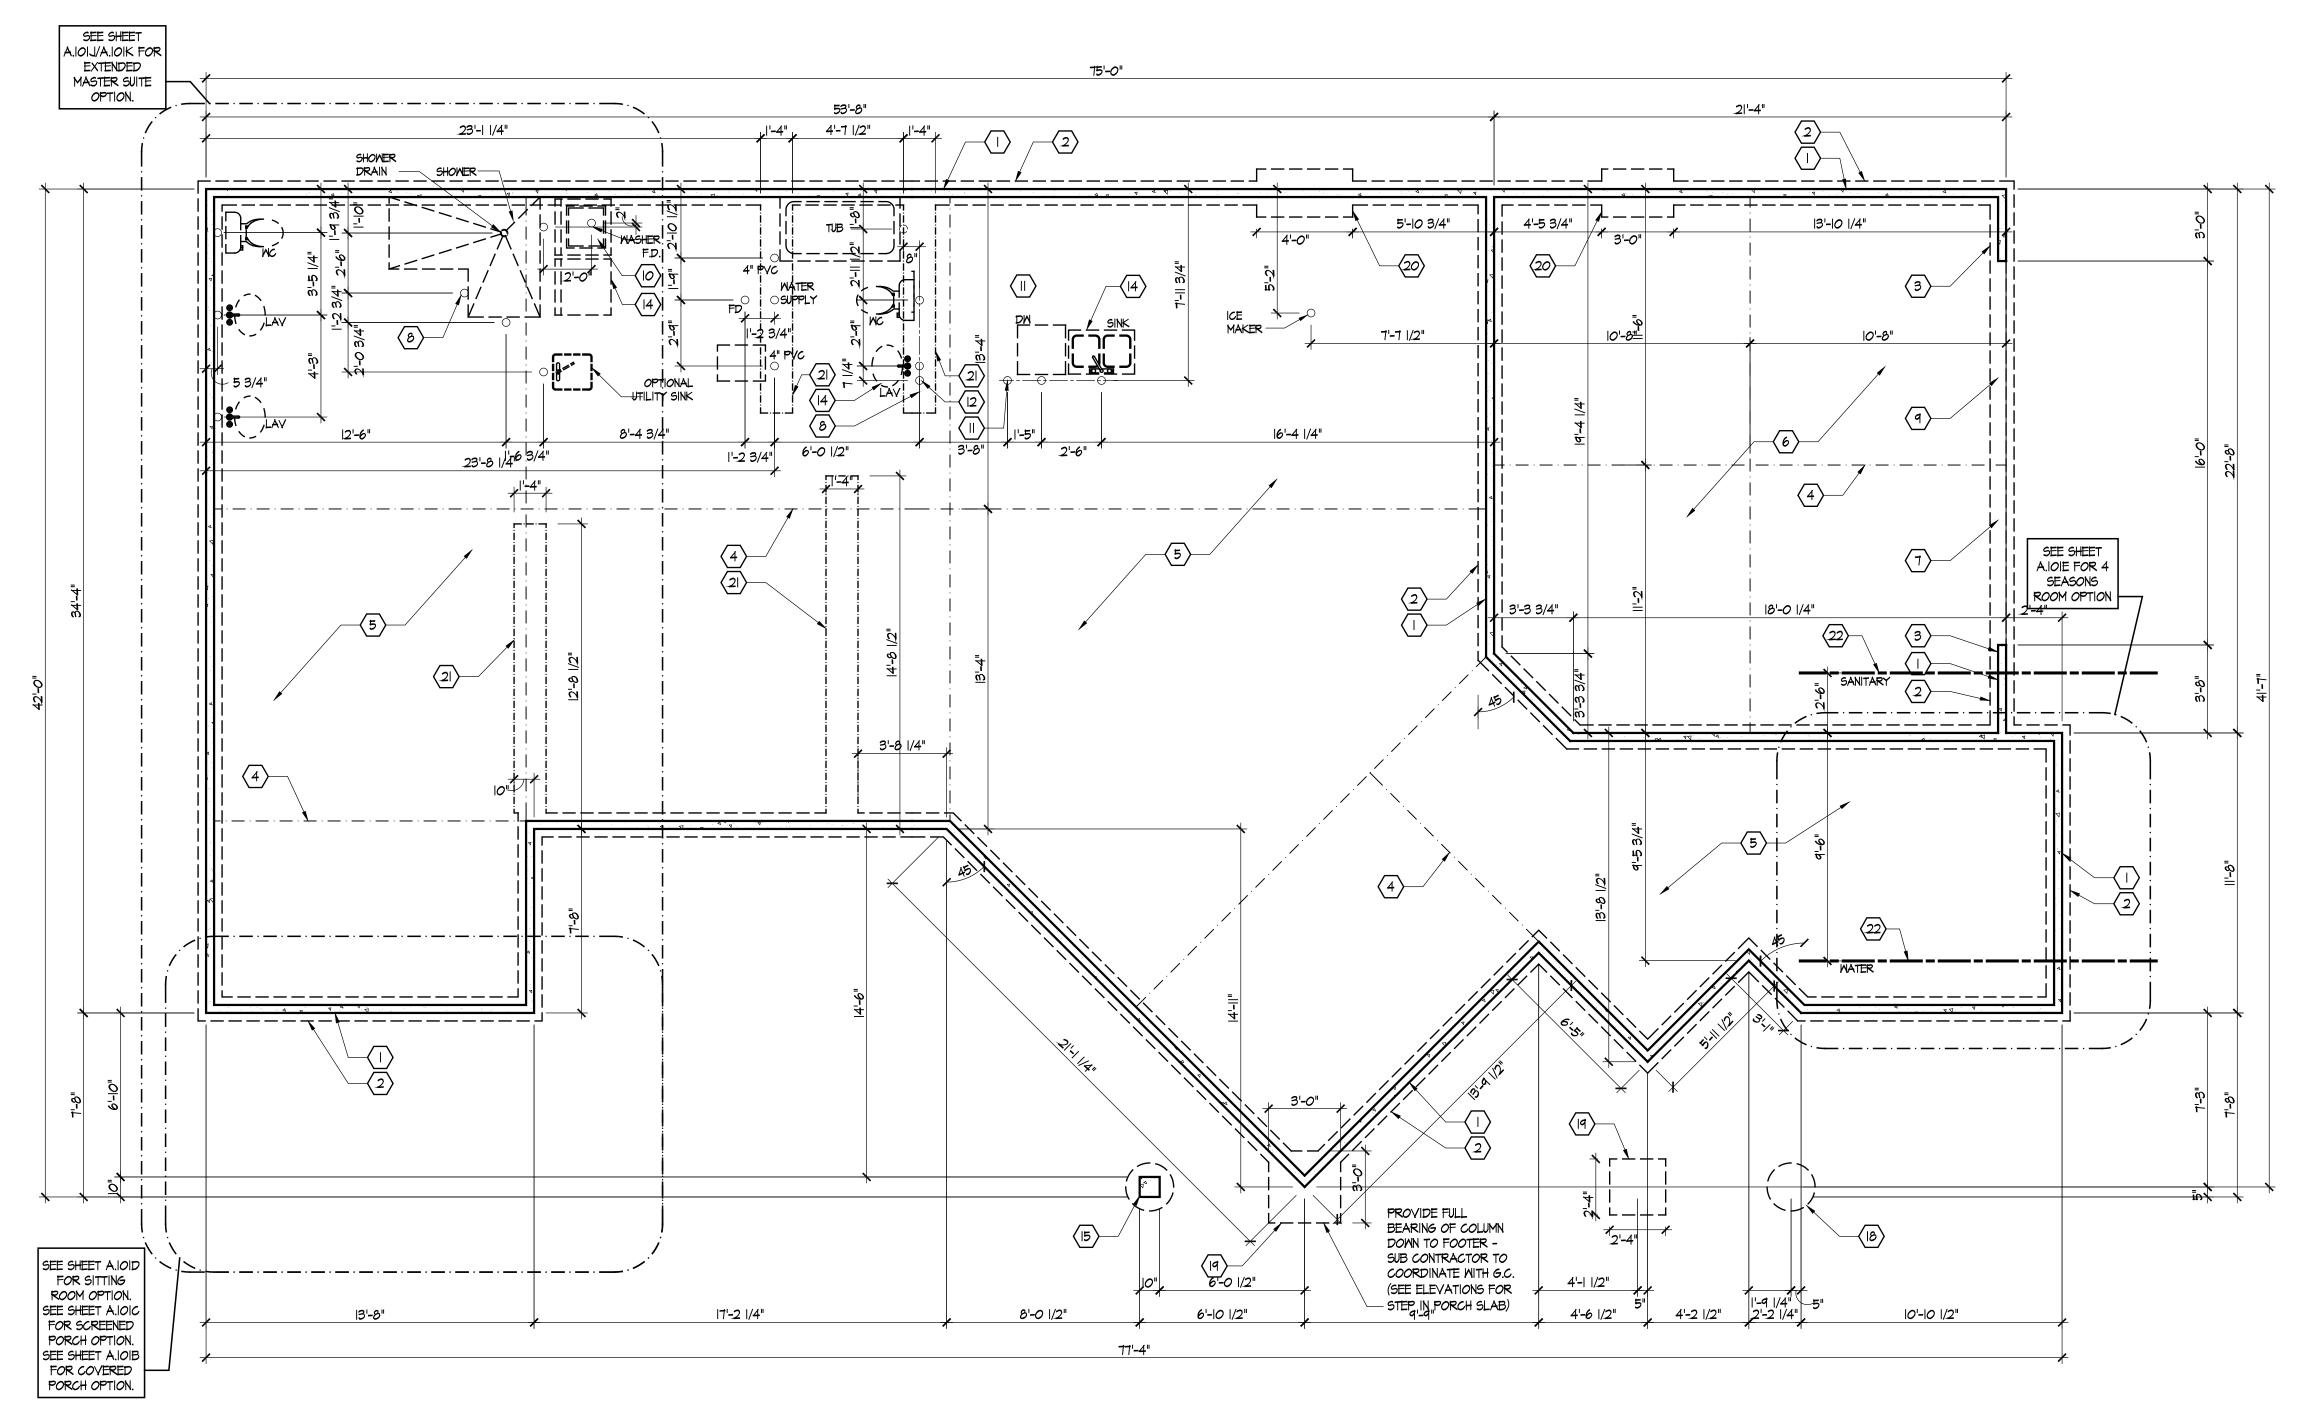

### Foundation Plan

Scale: 1/4" = 1'-0"

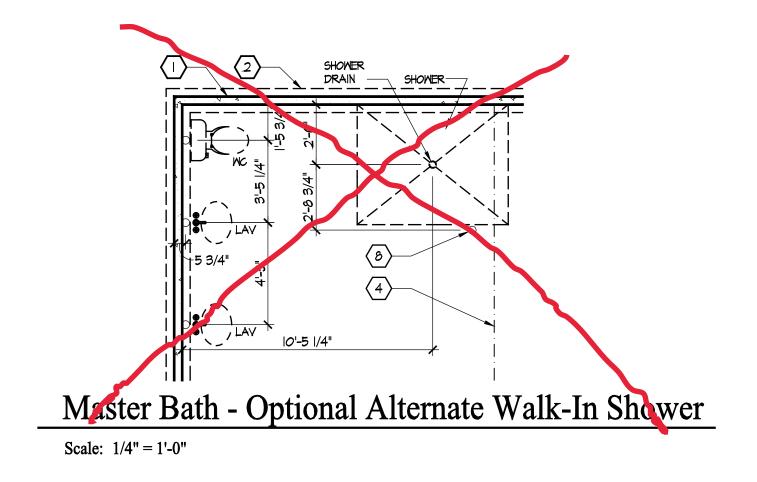

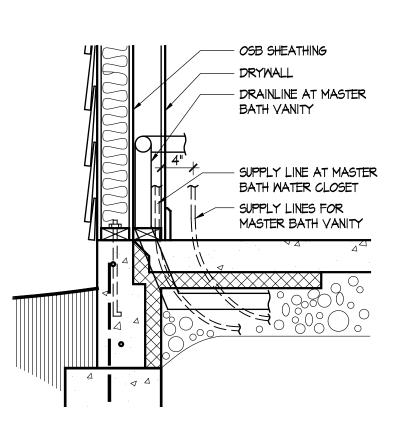

Master Bath Plumbing Detail - Vanity/W.C.

Scale: 1/4" = 1'-0"

### FOUNDATION CODED NOTES

(FOUNDATION PLAN ONLY)

(ALL NOTES NOT APPLICABLE TO ALL SHEETS)

I. POURED CONCRETE FOUNDATION STEM WALL (TYPICAL) - SEE WALL SECTIONS SHEETS.

- 2. 12" WIDE CONCRETE FOOTING WITH STEEL BAR REINFORCING AS REQUIRED BY SOILS ENGINEER MAINTAIN BOTTOM OF FOOTING A MINIMUM 30" BELOW FINISH GRADE AND TOP OF FOOTING SET 12" BELOW FINISHED FLOOR TYPICAL.
- 3. PROVIDE MIN. 2 ANCHOR BOLTS EACH SIDE OF GARAGE
- 4. SAW CUT CONTROL JOINT IN CONCRETE SLAB, 1/8" WIDE  $\times$  1/4 DEEP TYPICAL.
- 4" POURED CONCRETE FLOOR SLAB OVER 4 MIL.
   POLYETHYLENE VAPOR BARRIER AND 4" GRAVEL BASE -TYPICAL.
- 4" GLASS FIBER REINFORCED CONCRETE FLOOR SLAB OVER
   4" GRAVEL BASE TYPICAL IN GARAGES.
- 7. PROVIDE WEATHERLIP @ GARAGE DOOR OPENING SEE DETAIL D, SHEET A.301.
- 8. PIPE LOCATION CENTERED ON WALL ABOVE.
- 9. NO STEM WALL AT GARAGE DOOR OPENINGS.
- IO. MASHER ALMAYS LOCATED LEFT OF DRYER.
- II. ELECTRICAL CONDUIT UNDER SLAB FOR ELECTRICAL OUTLET AT KITCHEN ISLAND.
- 12. ELECTRICAL CONDUIT SLAB PENETRATION.
- 13. NOT USED.
- 14. DASHED LINES INDICATE LOCATION OF PLUMBING FIXTURES ABOVE SHOWN FOR REFERENCE ONLY.
- 15. IO" WIDE X IO" DEEP CONCRETE PIER WITH 24" DIA. FOOTING. MAINTAIN BOTTOM OF FOOTING A MINIMUM 30" BELOW FINISH GRADE AND TOP OF PIER SET 6" BELOW FINISHED FLOOR.
- 16. DOTTED LINE INDICATES WALL LINE OF BASE UNIT.
- 17. 8" DEEP X 16" WIDE THICKENED SLAB WITH (2) NO. 4 REBAR CONTINUOUS.
- 18. 24" DIA. FOOTING MAINTAIN BOTTOM OF FOOTING A MINIMUM 30" BELOW FINISH GRADE.
- 19. 12" DEEP CONCRETE FOOTING WITH (2) NO. 5 REBAR EACH WAY
   SEE PLANS FOR SIZE MAINTAIN BOTTOM OF FOOTING A
   MINIMUM 30" BELOW FINISH GRADE. 12" THICKENED SLAB EDGE
   TO CONTINUE DOWN TO FOOTING.
- 20. 24" WIDE CONCRETE FOOTING WITH STEEL BAR REINFORCING AS REQUIRED BY SOILS ENGINEER MAINTAIN BOTTOM OF FOOTING A MINIMUM 30" BELOW FINISH GRADE AND TOP OF FOOTING SET 12" BELOW FINISHED FLOOR.
- 21. 12" DEEP x 16" WIDE THICKENED SLAB WITH (2) NO. 4 REBAR CONTINUOUS. TYPICAL UNDER ALL INTERIOR SHEAR WALLS.
- 22. PLUMBER TO PROVIDE 4" PVC SLEEVE FOR WATER AND 4" SANITARY LINE FOR INSTALLATION BY FOOTER CONTRACTOR.

### GENERAL FOUNDATION NOTES

I. SOIL BEARING CAPACITY ASSUMED TO BE 2500 PSF AND SHALL BE VERIFIED BY SOILS ENGINEER PRIOR TO PLACEMENT OF BUILDING FOUNDATION. CONSULT ARCHITECT WHEN INADEQUATE SOIL CAPACITIES ARE FOUND.

2. ALL DIMENSIONS ARE TO FACE OF FOUNDATION / BASEMENT WALL UNLESS NOTED OTHERWISE.

3. HOLD DOWN TOP OF FOUNDATION WALL 8" AT ALL ENTRY DOORS TO ALLOW FOR EXTENSION OF FLOOR SLAB UNDER THE DOOR THRESHOLDS.

4. PLUMBING CONTRACTOR TO USE ROUND BUCKETS FOR FORMED SLAB PENETRATIONS.

5. CONCRETE CONTRACTOR TO INSTALL 1/2" EXP. JT. AROUND THE PERIMETER OF GARAGES.

6. CONCRETE CONTRACTOR COORDINATE WITH PLUMBING FOR LOCATION OF BLOCKOUTS FOR UNDERSLAB LINES.7. CONCRETE CONTRACTOR - SEE FIRST FLOOR PLAN FOR

SIDEMALKS AND PATIOS.

8. CONCRETE CONTRACTOR TO VERIFY SLAB PENETRATION AT TUB/SHOWER OPTIONS.

# EPCON

Where Life Comes Together

Communities

# Foundation Development Group, LLC & Bel Haven, LL Bel Haven

 $\frac{\text{PROPRIETARY RIGHTS NOTICE}}{\text{COPYRIGHT 2007 EPCON COMMUNITIES FRANCHISING, INC.}}$ 

ALL RIGHTS ARE RESERVED IN THIS INFORMATION AND ALL RELATED ILLUSTRATIONS, PLANS, BLUEPRINTS, SKETCHES, DRAWINGS, OR ANY OTHER TANGIBLE, EXPRESSIONS THEREOF, WHICH ARE THE PROPERTY OF EPCON COMMUNITIES FRANCHISING, INC., 500 STONEHENGE PARKWAY, DUBLIN, OHIO 43017, TELEPHONE 614.652.3527. NO ONE MAY BUILD, LICENSE, TRANSFER, REPRODUCE OR

DUPLICATE THIS WORK IN ANY WAY WITHOUT THE WRITTEN

AUTHORIZATION OF EPCON COMMUNITIES FRANCHISING, INC.

THESE DRAWINGS SHALL BE USED IN CONFORMANCE WITH ALL LOCAL BUILDING, MECHANICAL, PLUMBING AND ELECTRICAL CODES AND SHALL MEET THE REQUIREMENTS OF THE HEALTH DEPARTMENT, FIRE MARSHALL, AMERICANS WITH DISABILITIES ACT ACCESSIBILITY GUIDELINES (ADAAG), THE FAIR HOUSING ACT ACCESSIBILITY GUIDELINES (FHAAG), AND SHALL BE CONSTRUCTED IN CONFORMANCE WITH STATE AND LOCAL

ENERGY REQUIREMENTS.

Prototype	Interim Page Revisions	
Disk No.	Revision	Date
		8/1/10

Architect Project Number 2019-044


Community Dates & Revisions
Date Originated 20 FEB 2020
Bid
Permit
Construction

Revisions

Drawing Title
Foundation Plan

Architectural Style
European Country

Sheet Number
A.100
D3M - 2010 Bonus

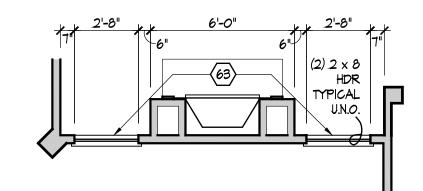

## Living Room - Optional Windows

**UNDER STAIR** 

STORAGE

7'-1 3/4"

ELEVATIONS

THIS WALL NEEDS TO BE 2x6 Scale: 1/4'' = 1'-0''have furred out on rough!! hold washer, box out

<del>\_\_\_(50)</del>(21)

BATH 2 82 5'-6"

**-**(54)

17'-2 1/4"

4'-2 3/4"

8'-0 1/2"

First Floor Plan

Scale: 1/4'' = 1'-0''

77'-4"

3'-3"

DINING

ROOM

16'-0 1/4"

0 0

24 29

3-0 MIDE x 7-8 16'-0 1/4"

63) SEE INT. ELEVATIONS

MULTI-PLY ROOF GIRDER TRUSS -

FLOOR LOADS FROM 2ND FLOOR

WITH BONUS ROOM OPTION

DESIGN TO CARRY BOTH ROOF AND

/ 9 I/4" LVL |

LIVING

ROOM

### GENERAL NOTES

I. EXTERIOR WALL DIMENSIONS INCLUDE THICKNESS OF SHEATHING

2. REFER TO SITE LAYOUT PLAN FOR BUILDING LOCATIONS AND ORIENTATIONS.

3. DOORS NOT OTHERWISE DIMENSIONED SHALL BE LOCATED WITH ROUGH OPENING 3" FROM INTERSECTING WALLS.

<del>-(41)</del>

(2) 2 × 8 HDR -

SEE SHEET A.IOIE FOR 4

**SEASONS** 

ROOM OPTION

4. AT SECOND FLOOR WALL LOCATIONS WITH PARALLEL FLOOR JOIST/TRUSSES - PROVIDE 2 X BLOCKING FULL DEPTH OF FLOOR

STRUCTURE BETWEEN JOISTS/TRUSSES @ 24" O.C..

<u>|6'-0" DOOR:</u>  $(2) 2 \times 12 \text{ WOOT}$ 

> <u> 18'-0" DOOR</u> <u>OPTION:</u>

(2) |-3/4" ||-|/4"

<u>NOTE:</u> 5/8" TYPE X

BONUS ROOM

(2) 2 × 8 HDR

TYPICAL U.N.O.

DRYWALL CEILING IN GARAGE WITH

GARAGE

LVL

MULTI-PLY ROOF GIRDER TRUSS - DESIGN TO

CARRY BOTH ROOF AND

FLOOR LOADS FROM

- ROOM OPTION

6'-5 1/2"

5'-6 3/4"

6'-4 3/4"

3'-8 1/2"

2ND FLOOR WITH BONUS

## TIRST FLOOR PLAN CODED NOTES

(ALL NOTES NOT APPLICABLE TO ALL SHEETS)

- EXTERIOR STUD WALL 2 X 4 WOOD STUDS AT 16" O.C. WITH 1/2" DRYWALL ON ALL INTERIOR SURFACES AND 1/16" O.S.B. SHEATHING ON EXTERIOR SURFACES - TYPICAL.
- 2. INTERIOR STUD WALL 2 X 4 WOOD STUDS AT 16" O.C. WITH 1/2" DRYWALL ON ALL FINISHED SURFACES
- FLAT DRYWALL CEILING @ 9'-0" A.F.F. TYPICAL UNLESS NOTED OTHERWISE.
- 4. 20" DEEP X 60" WIDE GRANITE HEARTH EXTENSION CENTERED ON FIREBOX.
- ISLAND BASE CABINETS & COUNTERTOP FINISH ALL EDGES OF CABINETS & COUNTERTOP.
- 6. TRAY CEILING @ IO'-O" A.F.F.
- PROVIDE FIBERGLASS BATT INSULATION IN GARAGE WALLS COMMON TO LIVING SPACE.
- MAINTAIN 4" MINIMUM ELEVATION CHANGE BETWEEN GARAGE FLOOR & FINISHED FIRST FLOOR.
- PREFABRICATED METAL FIREBOX UNIT HEARTH & HOME MODEL DY3T329BI (OR SIMILAR), PROVIDE GAS LINE, GAS LOG SET AND SCREEN - ROUGH OPENING 37" WIDE X 34 3/4" HIGH X I8" DEEP (26" DEEP WITH
- IO. OPTIONAL CABINETS SEE INTERIOR ELEVATIONS.
- WASHER LOCATION PROVIDE WASHER BOX ON BACK WALL. WASHER ALWAYS LOCATED LEFT OF
- 12. DRYER LOCATION DRYER VENT IN WALL
- 13. OPTIONAL UTILITY SINK AND FAUCET INSTALL ROUGH-IN PLUMING ONLY.
- SINGLE CLOSET ROD & SHELF (67 1/2" A.F.F.) VINYL COATED WIRE WITH STANDARD SPACING 15. ARCHED OPENING. SPRING POINT @ 7'-8" A.F.F. TOP OF ARCH 8'-6" ABOVE SPRING POINT.
- LOCATION OF DOUBLE 2 X 4 STUD WALL.
- FRAMELESS MIRROR LOCATION 42" HIGH  $\times$  2" SHORTER THAN VANITY TOP (I" EACH SIDE) SET BOTTOM OF MIRROR AT TOP OF BACKSPLASH.
- 18. VANITY BASE AND COUNTERTOP 31 1/2" A.F.F.
- 20. SELF-RIMMING COUNTER LAVATORY AND FAUCET.
- 21. 32" X 60" STANDARD TUB/SHOWER & FAUCET WITH CERAMIC TILE SURROUND.
- 22. TEMPERED GLASS SHOWER ENCLOSURE AND DOOR.
- 23. 22" x 54" OPTIONAL PULL DOWN STAIR LOCATED BETWEEN TRUSSES ABOVE. DRYWALL ON STAIR SHALL BE MOUNTED WITH SCREWS INTO THE TOP & BOTTOM DOOR CROSS SUPPORTS WITH THE CENTER GLUED LEAVING NO SCREMS EXPOSED.
- 24. BASE CABINETS AND COUNTERTOP
- 25. LINE OF WALL CABINETS ABOVE.
- 26. 24" LONG TOWEL BAR 54" A.F.F. (58" A.F.F. ABOVE TOILET)
- 27. REFRIGERATOR LOCATION.
- 28. DOUBLE BOWL SINK AND FAUCET
- 29. RANGE LOCATION.
- 30. DISHWASHER LOCATION. 31. IO" X IO" BUILT-UP COLUMN - TYPICAL. SEE DETAIL D, SHEET A.304 FOR MORE INFORMATION.
- 33. (4) 16" DEEP WIRE SHELVES (29", 42", 55", 68" A.F.F.) STANDARD SPACING. TYPICAL AT LINEN CLOSETS
- 34. FURNACE LOCATION.
- 35. TANKLESS WATER HEATER.
- 36. IO" X IO" BUILT-UP COLUMN / PILASTER TYPICAL. SEE DETAIL F, SHEET A.304 FOR MORE INFORMATION.
- 37. I6'-O" x 8"-O" ATTIC STORAGE ABOVE PROVIDE 3/4" APA RATED SUB-FLOORING ON BOTTOM CHORD OF TRUSSES. OSB SHEATHING RATED FOR 20 PSF LIVE LOAD IS PERMITTED AS AN ALTERNATE.
- 38. I/2 WALL TO UNDERSIDE OF BAR COUNTERTOP.

AND PANTRIES, UNLESS NOTED OTHERWISE.

- 39. HOSE BIBB LOCATION.
- 40. SURFACE MOUNTED ELECTRIC PANEL LOCATION.
- 41. PROVIDE (2) JACKS UNDER ALL HEADERS IN OPENINGS OVER 60" WIDE TYPICAL.
- 42. INDICATES MULTIPLE STUD COLUMN IN WALL TYPICAL AT BEARING OF ALL WOOD BEAMS, GIRDER TRUSSES UNLESS NOTED OTHERWISE. SEE PLAN FOR NUMBER OF STUDS REQUIRED.
- 43. MINIMUM 1/2" DRYWALL ON GARAGE SIDE.
- 44. 32" X 60" STANDARD SHOWER BASE.
- 45. CUSTOM TILED WALK-IN SHOWER BASE SEE PLAN FOR SIZE.
- 46. WOOD GUARD RAIL SEE DETAIL K ON SHEET A.304.
- 47. TILED CORNER SEAT OPTION 30" WIDE X 18" A.F.F HIGH.
- 48. FLAT DRYWALL CEILING ON UNDERSIDE OF BOTTOM CHORD OF ROOF TRUSSES OR FLOOR JOISTS.
- 49. FLAT DRYWALL CEILING @ 8'-4" A.F.F.
- 50. SOAP DISH 5" HIGH X 7" WIDE.
- 51. DOWNSPOUT LOCATION.
- 52. DOWNSPOUT DISCHARGED INTO BLACK PIPE AND ROUTED UNDER WALKS OR PATIO.
- 53. EDGE OF DRIVEWAY.
- 54. 4" THICK SLAB TYPICAL @ CONCRETE WALKS/PORCHES/PATIOS
- 55. CONTROL JOINTS TYPICAL.
- 56. DASHED LINES INDICATE BOXED BEAM ABOVE.
- 57. 12" DEEP SHELF (60" A.F.F.) VINYL COATED WIRE STANDARD SPACING.
- 58. SHOWER WALL 6'-0" A.F.F.
- 59. OPTIONAL GARAGE SHELVING.
- 60. OPTIONAL DESK.
- 61. COURTYARD GATE AND FENCE LOCATION.
- 62. DASHED LINE INDICATES OPTIONAL PATIO SECTION.
- 63. OPTIONAL MINDOW.
- 64. (4) 12" DEEP WIRE SHELVES (29", 42", 55", 68" A.F.F.) STANDARD SPACING.
- 65. 32" X 60" SHOWER BASE WITH BUILT-IN SEAT.
- 66. HARDBOARD TREADS AND RISERS.
- 67. WOOD HANDRAIL 34" ABOVE STAIR TREADS. RETURN ENDS TO WALL OR NEWEL POST.
- 68. SINGLE BOWL SINK AND FAUCET.
- 69. 20" RANGE LOCATION.

en, aven ation m 0

**EPCON** 

Communities

Where Life Comes Together

PROPRIETARY RIGHTS NOTICE COPYRIGHT 2007 EPCON COMMUNITIES FRANCHISING, INC.

ALL RIGHTS ARE RESERVED IN THIS INFORMATION AND ALL RELATED ILLUSTRATIONS, PLANS, BLUEPRINTS, SKETCHES, DRAWINGS, OR ANY OTHER TANGIBLE, EXPRESSIONS THEREOF, WHICH ARE THE PROPERTY OF EPCON COMMUNITIES FRANCHISING, INC., 500 STONEHENGE PARKWAY, DUBLIN, OHIO 43017, TELEPHONE 614.652.3527. NO ONE MAY BUILD, LICENSE, TRANSFER, REPRODUCE OR DUPLICATE THIS WORK IN ANY WAY WITHOUT THE WRITTEN

AUTHORIZATION OF EPCON COMMUNITIES FRANCHISING, INC. THESE DRAWINGS SHALL BE USED IN CONFORMANCE WITH ALL LOCAL BUILDING, MECHANICAL, PLUMBING AND ELECTRICAL CODES AND SHALL MEET THE REQUIREMENTS OF THE HEALTH DEPARTMENT, FIRE MARSHALL, AMERICANS WITH DISABILITIES ACT ACCESSIBILITY GUIDELINES (ADAAG), THE FAIR HOUSING ACT ACCESSIBILITY GUIDELINES (FHAAG), AND SHALL BE CONSTRUCTED IN CONFORMANCE WITH STATE AND LOCAL

Prototype Disk No.	Interim Page Revisions		
	Revision	Date	
		2/17/12	

ENERGY REQUIREMENTS.

Architect Project Number 2019-044


Community Dates & Revisions Date Originated 20 FEB 2020 Permit Construction Revisions

> **Drawing Title** First Floor Plan

Architectural Style **European Country** 

**Sheet Number** 

D3M - 2010 Bonus

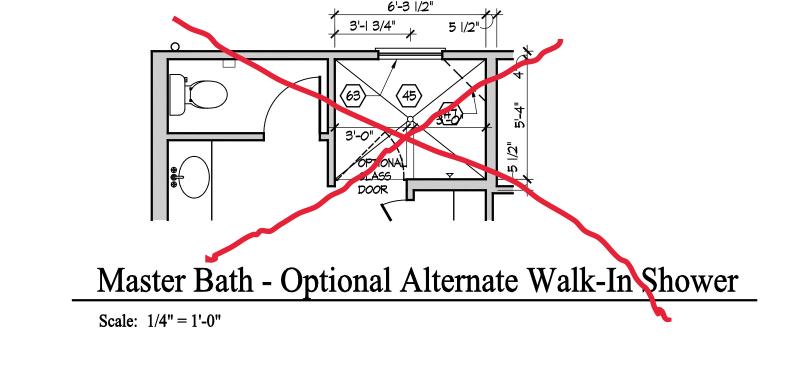

6'-3 1/2"

MASTER

BONUS

ROOM

**BEDROOM** 

FRENCH DOOR WITH

STATIONARY PANEL

AND IRANSOM

MASTER

**CLOSET** 

9'-0 1/2"

5'-11 1/2"

3'-|| |/2" | 3'-|| |/2"

BEDROOM 2

SEE SHEET 4.101J/A.101K FOR

EXTENDED MASTER SUITE

OPTION.

SEE SHEET A.IOID FOR SITTING

ROOM OPTION. SEE SHEET A.IOIC

FOR SCREENED PORCH OPTION.

SEE SHEET A.IOIB FOR COVERED

PORCH OPTION.

### 70. FLAT DRYWALL CEILING @ 8'-0" A.F.F..

10'-10 1/2"

11. LINE OF BREAK OF SLOPED DRYWALL CEILING - FOLLOW BOTTOM CHORD OF ROOF TRUSSES OR RAFTERS ABOVE.

E.Q.

- 72. SLOPED CEILING AREA ABOVE.
- 73. ATTIC ACCESS PANEL: 22" x 30" MINIMUM. PANEL TO BE 6" MIN. ABOVE BASE IF LOCATED IN KNEE WALL. PANEL TO HAVE I" QUARTER ROUND MOULDING AROUND EDGE. PANEL SHALL BE WEATHER-STRIPPED AND INSULATED TO A LEVEL EQUIVALENT TO THE INSULATION ON THE SURROUNDING SURFACES. IF IN THE CEILING, A BAFFLE IS REQUIRED TO CONTAIN LOOSE-FILL INSULATION.
- 14. UNDER THE COUNTER REFRIGERATOR LOCATION.
- 75. FLAT DRYWALL CEILING @ 7'-O" A.F.F..
- 76.  $2 \times 6$  HALF WALL @ 36" A.F.F. WITH I  $\times$  8 HARDWOOD CAP 1/2" LAG BOLT EACH END THRU SUB FLOOR.
- 77. SINGLE CLOSET ROD & SHELF (48" A.F.F.) VINYL COATED WIRE WITH STANDARD SPACING.
- 78. KNEE WALL: 2 x 4 WOOD STUDS AT 16" O.C. WITH 1/2" DRYWALL ON ALL INTERIOR SURFACES, AND 1/4" O.S.B. BACKER PANEL ON EXTERIOR SURFACES - TYPICAL. RUN FROM FLOOR STRUCTURE BELOW TO UNDERSIDE OF ROOF FRAMING.

79. NOT USED.

- 81. DASHED LINE INDICATES 8" CEILING SOFFIT FOR SANITARY LINES FROM BONUS ROOM.
- 82. TOWEL RING.

### GENERAL NOTES

31'-11 1/4"

SEE EXT

**ELEVATIONS** 

STORAGE

- I. EXTERIOR WALL DIMENSIONS INCLUDE THICKNESS OF SHEATHING.
- 2. REFER TO SITE LAYOUT PLAN FOR BUILDING LOCATIONS AND ORIENTATIONS.
- 3. DOORS NOT OTHERWISE DIMENSIONED SHALL BE LOCATED WITH ROUGH OPENING 3" FROM INTERSECTING WALLS.
- 4. AT SECOND FLOOR WALL LOCATIONS WITH PARALLEL FLOOR JOIST/TRUSSES - PROVIDE 2 X BLOCKING FULL DEPTH OF FLOOR STRUCTURE BETWEEN JOISTS/TRUSSES @ 24" O.C..


15'-6 1/4"

15'-2 1/4"

LIVING AREA

### 2nd floor bath and wet bar

2'-10"

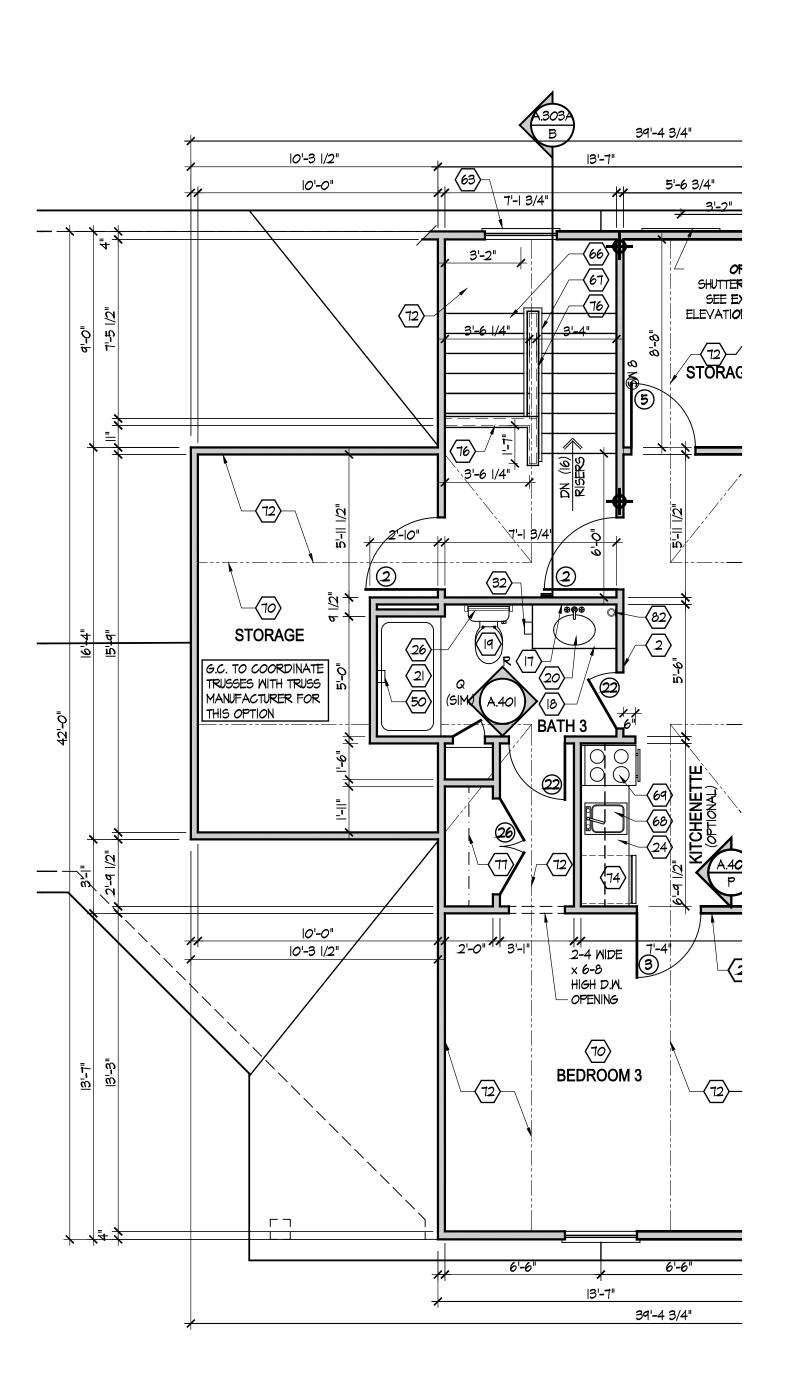

Second Floor Plan - Additional Storage Option Scale: 1/4" = 1'-0"

## Second Floor Plan Scale: 1/4'' = 1'-0''

31'-11 1/4"

<del>--(12)--</del>

2-4 WIDE x

HIGH D.W.

-OPENING

BEDROOM 3

. 2'-10"

### 70. FLAT DRYWALL CEILING @ 8'-0" A.F.F..

15'-6 1/4"

11. LINE OF BREAK OF SLOPED DRYWALL CEILING - FOLLOW BOTTOM CHORD OF ROOF TRUSSES OR RAFTERS ABOVE.

2'-0" 2'-0"

- 72. SLOPED CEILING AREA ABOVE.
- 73. ATTIC ACCESS PANEL: 22" x 30" MINIMUM. PANEL TO BE 6" MIN. ABOVE BASE IF LOCATED IN KNEE WALL. PANEL TO HAVE I" QUARTER ROUND MOULDING AROUND EDGE. PANEL SHALL BE MEATHER-STRIPPED AND INSULATED TO A LEVEL EQUIVALENT TO THE INSULATION ON THE SURROUNDING SURFACES. IF IN THE CEILING, A BAFFLE IS REQUIRED TO CONTAIN LOOSE-FILL INSULATION.
- 14. UNDER THE COUNTER REFRIGERATOR LOCATION.
- 75. FLAT DRYWALL CEILING @ 7'-O" A.F.F..
- 76.  $2 \times 6$  HALF WALL @ 36" A.F.F. WITH I  $\times$  8 HARDWOOD CAP I/2" LAG BOLT EACH END THRU SUB FLOOR.
- 17. SINGLE CLOSET ROD & SHELF (48" A.F.F.) VINYL COATED WIRE WITH STANDARD SPACING.
- 78. KNEE WALL: 2 x 4 WOOD STUDS AT 16" O.C. WITH 1/2" DRYWALL ON ALL INTERIOR SURFACES, AND 1/4" O.S.B. BACKER PANEL ON EXTERIOR SURFACES - TYPICAL. RUN FROM FLOOR STRUCTURE BELOW TO UNDERSIDE OF ROOF FRAMING.
- 79. NOT USED.
- 81. DASHED LINE INDICATES 8" CEILING SOFFIT FOR SANITARY LINES FROM BONUS ROOM.
- 82. TOWEL RING.

### FIRST FLOOR PLAN CODED NOTES (FIRST FLOOR UNIT PLANS ONLY)

6. TRAY CEILING @ 10'-0" A.F.F.

- (ALL NOTES NOT APPLICABLE TO ALL SHEETS)
- EXTERIOR STUD WALL -2 X 4 WOOD STUDS AT 16" O.C. WITH 1/2" DRYWALL ON ALL INTERIOR SURFACES AND 7/16" O.S.B. SHEATHING ON EXTERIOR SURFACES - TYPICAL.
- 2. INTERIOR STUD WALL 2 X 4 WOOD STUDS AT 16" O.C. WITH 1/2" DRYWALL ON ALL FINISHED SURFACES
- 3. FLAT DRYWALL CEILING @ 9'-0" A.F.F. TYPICAL UNLESS NOTED OTHERWISE. 4. 20" DEEP X 60" WIDE GRANITE HEARTH EXTENSION - CENTERED ON FIREBOX.
- 5. ISLAND BASE CABINETS & COUNTERTOP FINISH ALL EDGES OF CABINETS & COUNTERTOP.
- 7. PROVIDE FIBERGLASS BATT INSULATION IN GARAGE WALLS COMMON TO LIVING SPACE.
- MAINTAIN 4" MINIMUM ELEVATION CHANGE BETWEEN GARAGE FLOOR & FINISHED FIRST FLOOR.
- 9. PREFABRICATED METAL FIREBOX UNIT HEARTH & HOME MODEL DV37325BI (OR SIMILAR), PROVIDE GAS LINE, GAS LOG SET AND SCREEN - ROUGH OPENING 31" WIDE  $\times$  34 3/4" HIGH  $\times$  18" DEEP (26" DEEP WITH
- 10. OPTIONAL CABINETS SEE INTERIOR ELEVATIONS.
- WASHER LOCATION PROVIDE WASHER BOX ON BACK WALL. WASHER ALWAYS LOCATED LEFT OF
- 12. DRYER LOCATION DRYER VENT IN WALL.
- 13. OPTIONAL UTILITY SINK AND FAUCET INSTALL ROUGH-IN PLUMING ONLY.
- 14. SINGLE CLOSET ROD & SHELF (67 1/2" A.F.F.) VINYL COATED WIRE WITH STANDARD SPACING.
- 15. ARCHED OPENING. SPRING POINT @ 7'-8" A.F.F. TOP OF ARCH 8'-6" ABOVE SPRING POINT.
- 16. LOCATION OF DOUBLE 2 X 4 STUD WALL.
- 17. FRAMELESS MIRROR LOCATION 42" HIGH  $\times$  2" SHORTER THAN VANITY TOP (I" EACH SIDE) SET BOTTOM OF MIRROR AT TOP OF BACKSPLASH.
- 18. VANITY BASE AND COUNTERTOP 31 1/2" A.F.F.
- 20. SELF-RIMMING COUNTER LAVATORY AND FAUCET.
- 21. 32" X 60" STANDARD TUB/SHOWER & FAUCET WITH CERAMIC TILE SURROUND.
- 22. TEMPERED GLASS SHOWER ENCLOSURE AND DOOR.
- 23. 22" x 54" OPTIONAL PULL DOWN STAIR LOCATED BETWEEN TRUSSES ABOVE. DRYWALL ON STAIR SHALL BE MOUNTED WITH SCREMS INTO THE TOP & BOTTOM DOOR CROSS SUPPORTS WITH THE CENTER GLUED LEAVING NO SCREMS EXPOSED.
- 24. BASE CABINETS AND COUNTERTOP.
- 25. LINE OF WALL CABINETS ABOVE.
- 26. 24" LONG TOWEL BAR 54" A.F.F. (58" A.F.F. ABOVE TOILET).
- 27. REFRIGERATOR LOCATION.
- 28. DOUBLE BOWL SINK AND FAUCET.
- 29. RANGE LOCATION.
- 30. DISHWASHER LOCATION.
- 31. IO" X IO" BUILT-UP COLUMN TYPICAL. SEE DETAIL D, SHEET A.304 FOR MORE INFORMATION.
- 33. (4) 16" DEEP WIRE SHELVES (29", 42", 55", 66" A.F.F.) STANDARD SPACING. TYPICAL AT LINEN CLOSETS AND PANTRIES, UNLESS NOTED OTHERWISE.
- 34. FURNACE LOCATION.
- 35. TANKLESS WATER HEATER.
- 36. IO" X IO" BUILT-UP COLUMN / PILASTER TYPICAL. SEE DETAIL F, SHEET A.304 FOR MORE INFORMATION.
- 37. I6'-O" x 8"-O" ATTIC STORAGE ABOVE PROVIDE 3/4" APA RATED SUB-FLOORING ON BOTTOM CHORD OF TRUSSES. OSB SHEATHING RATED FOR 20 PSF LIVE LOAD IS PERMITTED AS AN ALTERNATE.
- 38. I/2 WALL TO UNDERSIDE OF BAR COUNTERTOP.
- 39. HOSE BIBB LOCATION.
- 40. SURFACE MOUNTED ELECTRIC PANEL LOCATION.
- 41. PROVIDE (2) JACKS UNDER ALL HEADERS IN OPENINGS OVER 60" WIDE TYPICAL.
- 42. INDICATES MULTIPLE STUD COLUMN IN WALL TYPICAL AT BEARING OF ALL WOOD BEAMS, GIRDER TRUSSES UNLESS NOTED OTHERWISE. SEE PLAN FOR NUMBER OF STUDS REQUIRED.
- 43. MINIMUM I/2" DRYWALL ON GARAGE SIDE.
- 44. 32" X 60" STANDARD SHOWER BASE.
- 45. CUSTOM TILED WALK-IN SHOWER BASE SEE PLAN FOR SIZE.
- 46. WOOD GUARD RAIL SEE DETAIL K ON SHEET A.304.
- 47. TILED CORNER SEAT OPTION 30" WIDE X 18" A.F.F HIGH.
- 48. FLAT DRYWALL CEILING ON UNDERSIDE OF BOTTOM CHORD OF ROOF TRUSSES OR FLOOR JOISTS.
- 49. FLAT DRYWALL CEILING @ 8'-4" A.F.F.
- 50. SOAP DISH 5" HIGH X 7" WIDE.
- 51. DOWNSPOUT LOCATION.
- 52. DOWNSPOUT DISCHARGED INTO BLACK PIPE AND ROUTED UNDER WALKS OR PATIO.
- 53. EDGE OF DRIVEWAY.
- 54. 4" THICK SLAB TYPICAL @ CONCRETE WALKS/PORCHES/PATIOS
- 55. CONTROL JOINTS TYPICAL.
- 56. DASHED LINES INDICATE BOXED BEAM ABOVE. 57. 12" DEEP SHELF (60" A.F.F.) - VINYL COATED WIRE - STANDARD SPACING.
- 58. SHOWER WALL 6'-0" A.F.F.
- 59. OPTIONAL GARAGE SHELVING.
- 60. OPTIONAL DESK.
- 61. COURTYARD GATE AND FENCE LOCATION.
- 62. DASHED LINE INDICATES OPTIONAL PATIO SECTION.
- 63. OPTIONAL WINDOW.
- 64. (4) 12" DEEP WIRE SHELVES (29", 42", 55", 68" A.F.F.) STANDARD SPACING.
- 65. 32" X 60" SHOWER BASE WITH BUILT-IN SEAT.
- 66. HARDBOARD TREADS AND RISERS.
- 67. WOOD HANDRAIL 34" ABOVE STAIR TREADS. RETURN ENDS TO WALL OR NEWEL POST.
- 68. SINGLE BOWL SINK AND FAUCET.
- 69. 20" RANGE LOCATION.

**EPCON** Communities

Where Life Comes Together \*

en, ation  $\mathbf{\tilde{\omega}}$ 0 Q

PROPRIETARY RIGHTS NOTICE

COPYRIGHT 2007 EPCON COMMUNITIES FRANCHISING, INC. ALL RIGHTS ARE RESERVED IN THIS INFORMATION AND ALL RELATED ILLUSTRATIONS, PLANS, BLUEPRINTS, SKETCHES, DRAWINGS, OR ANY OTHER TANGIBLE, EXPRESSIONS THEREOF, WHICH ARE THE PROPERTY OF EPCON COMMUNITIES FRANCHISING, INC., 500 STONEHENGE PARKWAY, DUBLIN, OHIO 43017, TELEPHONE 614.652.3527. NO ONE MAY BUILD, LICENSE, TRANSFER, REPRODUCE OR

DUPLICATE THIS WORK IN ANY WAY WITHOUT THE WRITTEN

ENERGY REQUIREMENTS.

AUTHORIZATION OF EPCON COMMUNITIES FRANCHISING, INC. THESE DRAWINGS SHALL BE USED IN CONFORMANCE WITH ALL LOCAL BUILDING, MECHANICAL, PLUMBING AND ELECTRICAL CODES AND SHALL MEET THE REQUIREMENTS OF THE HEALTH DEPARTMENT, FIRE MARSHALL, AMERICANS WITH DISABILITIES ACT ACCESSIBILITY GUIDELINES (ADAAG), THE FAIR HOUSING ACT ACCESSIBILITY GUIDELINES (FHAAG), AND SHALL BE CONSTRUCTED IN CONFORMANCE WITH STATE AND LOCAL

	Prototype Disk No.	Interim Page Revisions		
		Revision	Date	
			2/17/12	

Architect Project Number 2019-044

Community Dates & Revisions 20 FEB 2020 Date Originated Permit

Construction Revisions

> Drawing Title Second Floor Plan

Architectural Style **European Country** 

Sheet Number

D3M - 2010 Bonus